

Consulting Engineer's Certification
 I, Mitchell GASSMAN, hereby certify that the As Constructed information shown on this plan is a true and correct record of the sizes, types, materials, classes etc., and it corresponds with the relevant approved Engineering Drawings.
 Signed: [Signature] RPEQ No 16939 Dated: 05/12/2023

Registered Surveyor's Certification
 I, Anthony GERAGHTY, hereby certify that the horizontal and vertical locations, and dimensions shown on this plan are a true and correct record of the As Constructed information.
 Signed: [Signature] Reg. No 3222 Dated: 05/12/2023

NOTES
 ALL SEWER LINES 150Ø uPVC SN8 u.n.o
 ALL SEWER HOUSE CONNECTIONS 100Ø uPVC SN6 u.n.o.

- LEGEND**
- SEWER MAINTENANCE SHAFT
 - ⊙ SEWER MANHOLE
 - RODDING END
 - SEWER BEND
 - SEWER LINES
 - SEWER HOUSE CONNECTIONS
 - SEWER ENDCAP
 - - - PROPOSED EASEMENT



est 1985
 planning | environment | landscape | engineering | survey
 T: 3807 3333 | F: 3287 5461 | www.gassman.com.au
 Gold Coast | 76 Business Street, Yatala QLD | PO Box 392, Beenleigh 4207

Issue	Date	Description	SH	TH	CHK
-	05-12-2023	ORIGINAL ISSUE			

Project: **RIVERTON**
 Cusack Lane, Jimboomba

Client: **A.V.JENNINGS**

©2012 Gassman Development Perspectives
 All rights reserved. No part of this document may be reproduced or transmitted in any form or by any means, electronic, mechanical, photocopying, recording, or otherwise, without the written permission of Gassman Development Perspectives.

Scale at A1: **1:500**
 Date: **06-12-23**
 Surveyed: **TH**
 Drawn: **SH**
 Checked: **TH**

Drawing Title:
**AS CONSTRUCTED PLAN
 SUBMISSION 2
 STAGE 4A SEWER**


Drawing No: **5544 500 STG 4A SUBMISSION 2 - SEWER** Revision No:

Consulting Engineers Certification
 I, Mitchell GASSMAN, hereby certify that the As Constructed information shown on this plan is a true and correct record of the sizes, types, materials, classes etc., and it corresponds with the relevant approved Engineering Drawings.
 Signed: [Signature] RPEQ No 16939 Dated: 22/12/2023

Registered Surveyor's Certification
 I, Anthony GERAGHTY, hereby certify that the horizontal and vertical locations, and dimensions shown on this plan are a true and correct record of the As Constructed information.
 Signed: [Signature] Reg. No 3222 Dated: 22/12/2023

NOTES
 ALL SEWER LINES 150Ø uPVC SN8 u.n.o
 ALL SEWER HOUSE CONNECTIONS 100Ø uPVC SN6 u.n.o.

- LEGEND**
- SEWER MAINTENANCE SHAFT
 - SEWER MANHOLE
 - RODDING END
 - SEWER BEND
 - SEWER LINES
 - SEWER HOUSE CONNECTIONS
 - SEWER ENDCAP
 - PROPOSED EASEMENT

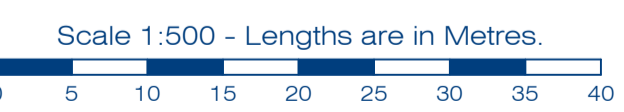

gassman development perspectives
 est 1985
 planning | environment | landscape | engineering | survey
 T: 3807 3333 | F: 3287 5461 | www.gassman.com.au
 Gold Coast | 76 Business Street, Yatala QLD | PO Box 392, Beenleigh 4207

Issue	Date	Description	TGPF	TH	CHK
-	22-12-2023	ORIGINAL ISSUE	TGPF	TH	CHK

Project: **RIVERTON**
 Cusack Lane, Jimboomba

Client: **A.V.JENNINGS**

©2012 Gassman Development Perspectives
 All rights reserved. No part of this document may be reproduced or transmitted in any form or by any means, electronic, mechanical, photocopying, recording, or otherwise, without the written permission of Gassman Development Perspectives.

Scale at A1: **1:500**
 Date: **22-12-23**
 Surveyed: **TH**
 Drawn: **TGP**
 Checked: **TH**

Drawing Title: **AS CONSTRUCTED PLAN STAGE 4Aii SEWER**

Drawing No: **5544 500 STG 4Aii - SEWER** Revision No: _____

SEE CONTINUATION BELOW